


SUITE 180

CARROLLWOOD CROSSINGS
4012 GUNN HWY, TAMPA

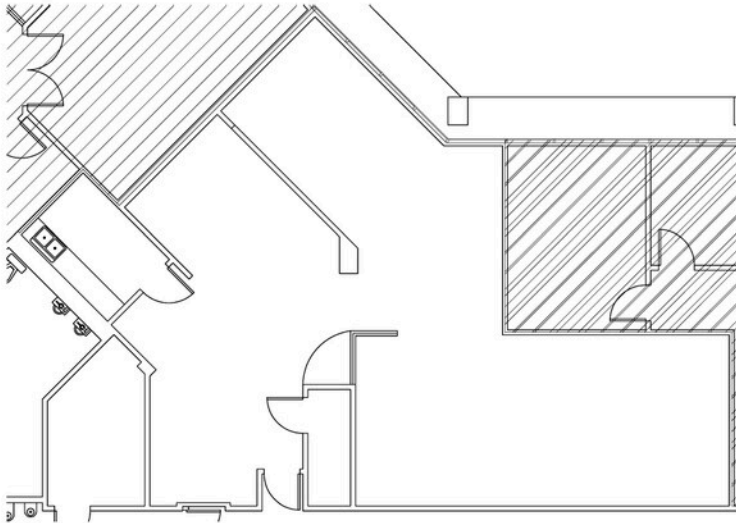

AS-BUILT

SCALE: 3/32" = 1'-0"

06-15-11



KEY PLAN

NOT TO SCALE