


# SUITE 160

CARROLLWOOD CROSSINGS - BUILDING 4014 - 1ST FLOOR

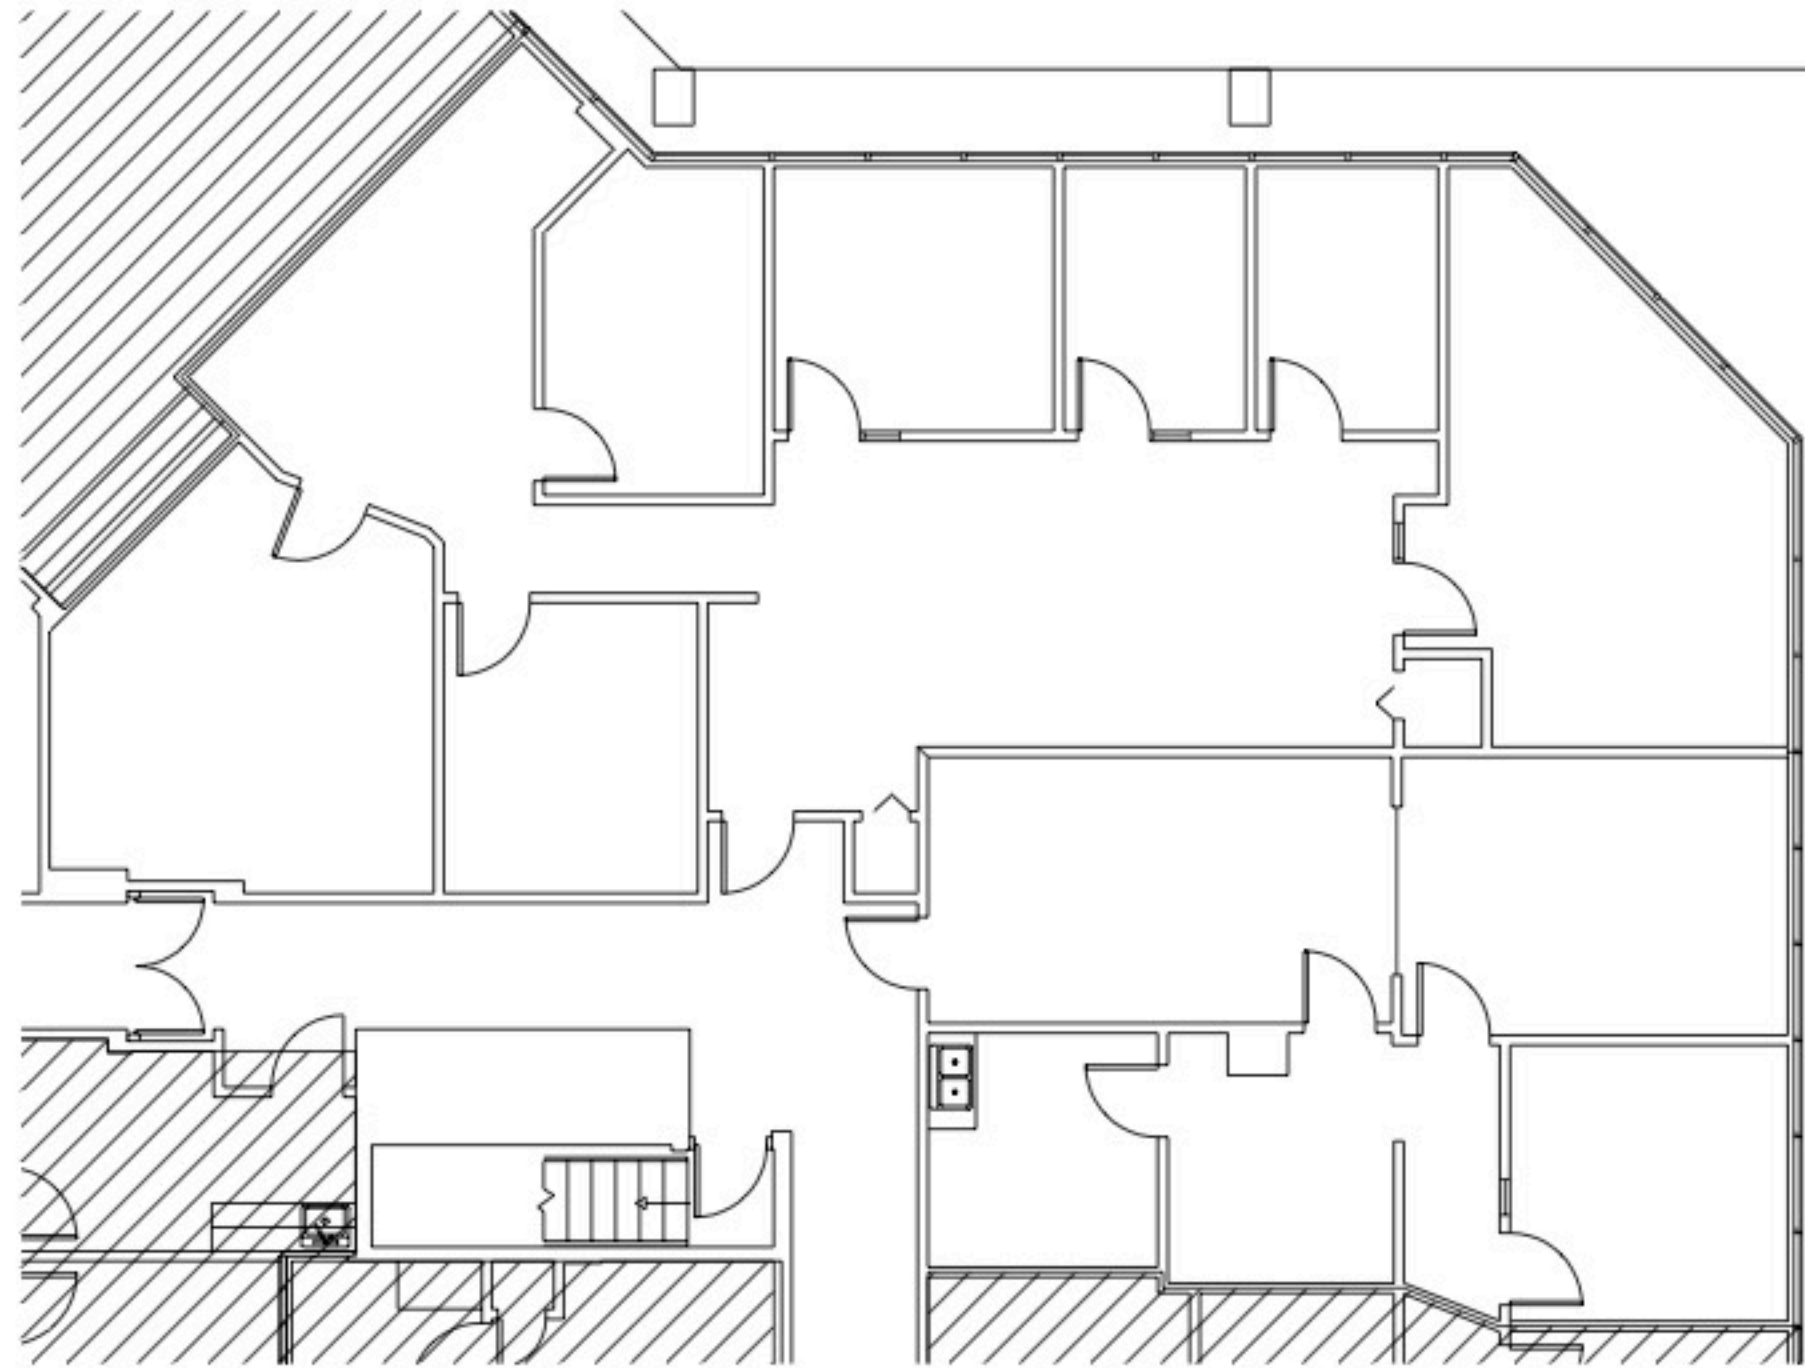

3,072 RSF



KEY PLAN

AS-BUILT

SCALE: 1/16" = 1'-0"

06-15-11